


DWG. NO. PTC.2211120-1

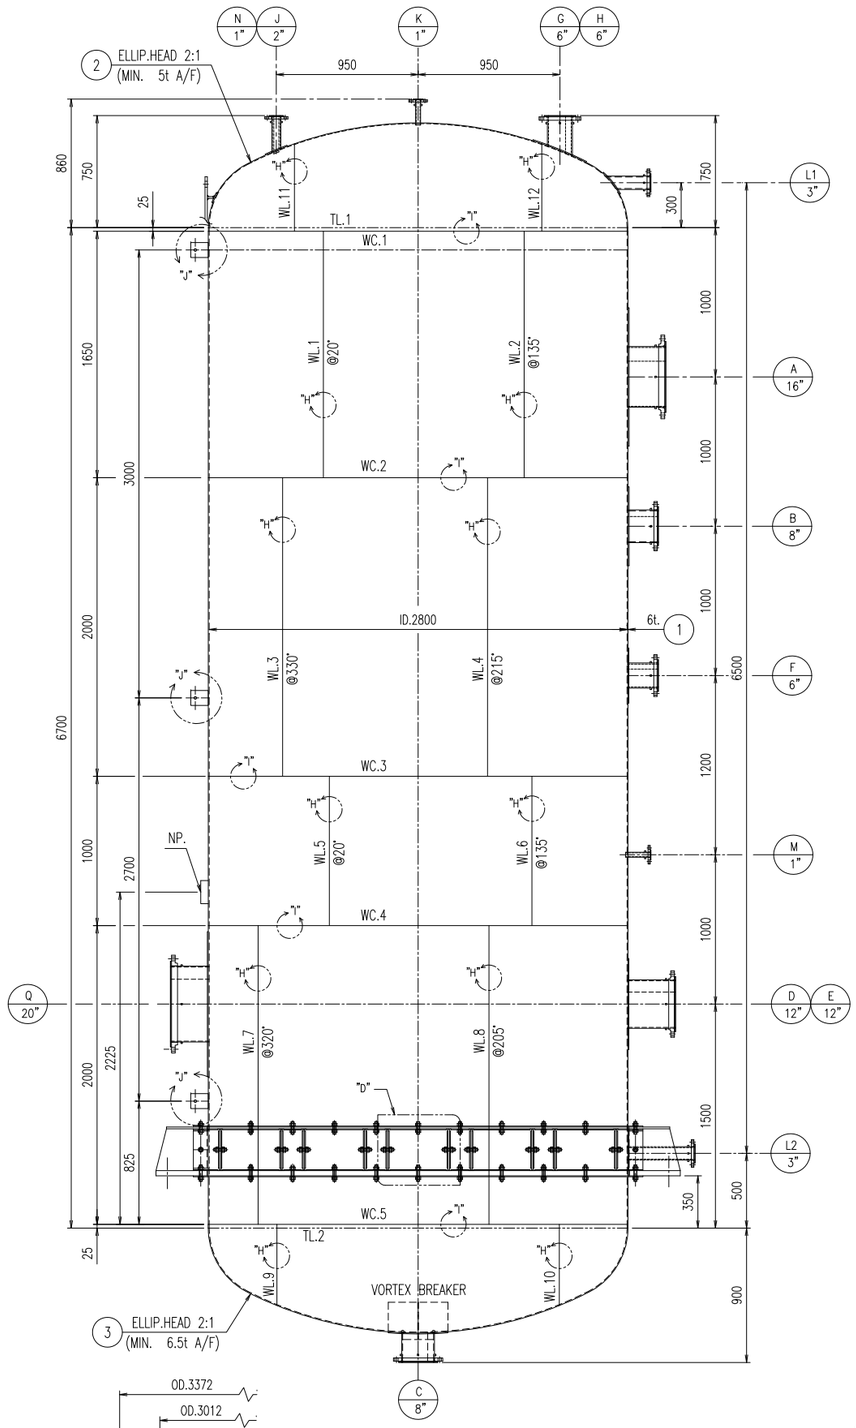

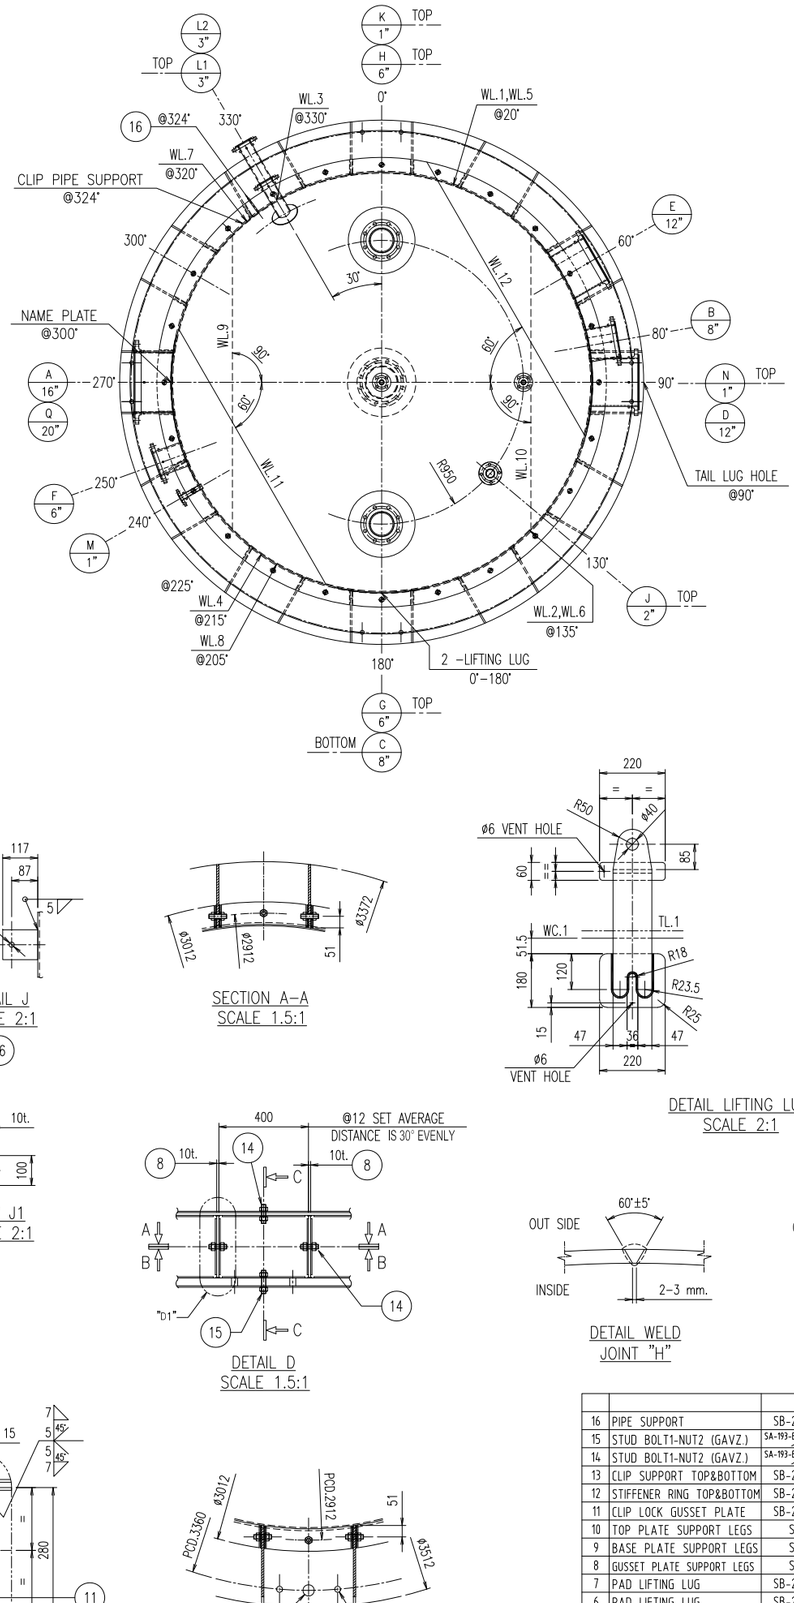

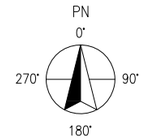

DESIGN DATA			
CODE	ASME SECTION VIII DIVISION 1, 2021 EDITION METRIC (ONLY DESIGN)		
FLUID NAME		C3H5ClO	
FLUID TYPE		-	
PRESS. MPa (G)	DESIGN	0.19	
	OPERATING	-	
	HYDRO. TEST	0.28	
	PNUEM. TEST	-	
TEMP. (°C)	DESIGN	80	
	OPERATING	-	
M.D.M.T.		-29 °C	
CORROSION ALLOWANCE		Ti : 0 mm.	
RADIOGRAPHY (CYL/HEAD)		FULL / FULL	
JOINT EFFICIENCY (CYL/HEAD)		1.0 / 1.0	
M.A.W.P. (HOT&CORRODED)	PRESS	200 kPa @ 80 °C	
	LIMITING PART	-	
STRESS RELIEVED (HEAD)		NO	
POSTWELD HEAT TREATMENT		NO	
INSULATION (mm.)		NO	
FIFREPROOFING (mm.)		NO	
PAINTING (CS PART ONLY)		YES	
CAPACITY		47,002	Liter
WEIGHT	EMPTY	4,037	Kgs
	OPERATING	42,822	Kgs
	FULL WATER	51,039	Kgs
WIND FACTOR		50 (UBC-1997)	m/s
SEISMIC FACTOR		0.3 (UBC-1997-BUILDING SUPPORT)	


NOZZLE LIST (PER ITEM)

No	SIZE	Q'TY	REINF. PAD THK	REINF. PAD O.D	FLANGE RATING	SERVICE / NOTE	REMARK
A	16"	1	6t	ø926	L.JF.JIS10K/RF.	LIQUID INLET	
B	8"	1	6t	ø530	L.JF.JIS10K/RF.	LIQUID INLET	
C	8"	1	6t	ø400	L.JF.JIS10K/RF.	LIQUID OUTLET	
D	12"	1	8t	ø610	L.JF.JIS10K/RF.	LIQUID OUTLET	
E	12"	1	8t	ø610	L.JF.JIS10K/RF.	LIQUID OUTLET	
F	6"	1	6t	ø368	L.JF.JIS10K/RF.	IW.INLET	
G	6"	1	6t	ø385	L.JF.JIS10K/RF.	AIR INLET	
H	6"	1	6t	ø385	L.JF.JIS10K/RF.	AIR OUTLET	
J	2"	1	6t	ø156	L.JF.JIS10K/RF.	BALANCE	
K	1"	1	-	-	L.JF.JIS10K/RF.	VENT	
L1	3"	1	6t	ø180	L.JF.JIS10K/RF.	LI (-)	
L2	3"	1	6t	ø180	L.JF.JIS10K/RF.	LI (+)	
M	1"	1	-	-	L.JF.JIS10K/RF.	TH.	
N	1"	1	-	-	L.JF.JIS10K/RF.	LIQUID INLET	
Q	20"	1	6t	ø970	L.JF.JIS5K/RF.	MANHOLE	WITH BLIND

NOZZLE LOADS

NOZZLE MARK	DN	DIRECT LOADS Vl/(N)	Vc/(N)	Pr/(N)	MOMENT LOADS Mc/(N-m)	Ml/(N-m)	Mr/(N-m)	CONNECTED PIPE NPS	SCH
K	25	-	-	-	-	-	-	1"	40
M	25	-	-	-	-	-	-	1"	40
N	25	-	-	-	-	-	-	1"	40
J	50	1646	1646	1290	271	339	434	2"	40
L1	50	1646	1646	1290	271	339	434	2"	40
L2	50	1646	1646	1290	271	339	434	2"	40
P	80	2358	2358	1868	583	732	936	3"	40
F	150	4448	4448	3559	2074	2630	3335	6"	Thk.6
G	150	4448	4448	3559	2074	2630	3335	6"	Thk.6
H	150	4448	4448	3559	2074	2630	3335	6"	Thk.6
B	200	5783	5783	4626	3498	4447	5654	8"	Thk.6
C	200	5783	5783	4626	3498	4447	5654	8"	Thk.6
D	350	7019	7019	5605	6907	8769	11161	12"	Thk.6
E	350	7019	7019	5605	6907	8769	11161	12"	Thk.6
A	400	8541	8541	6832	7216	9168	11665	16"	Thk.6
Q	500	-	-	-	-	-	-	20"	Thk.6




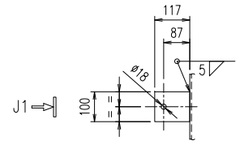

DETAIL J
SCALE 2:1


16

SECTION A-A
SCALE 1.5:1

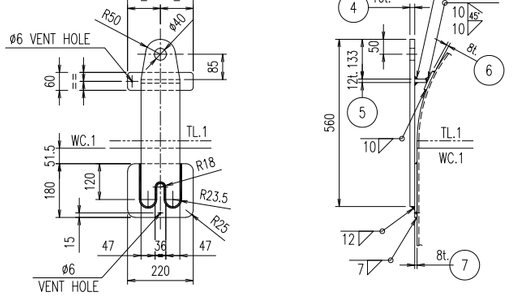


DETAIL LIFTING LUG
SCALE 2:1


DETAIL D
SCALE 1.5:1

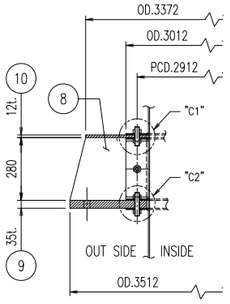


SECTION C-C
SCALE 1.5:1

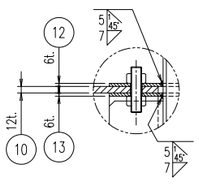


DETAIL C1

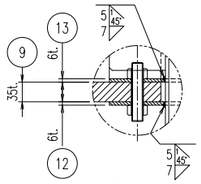

DETAIL C2

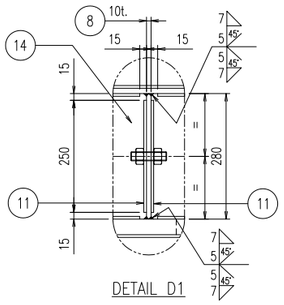


DETAIL D1

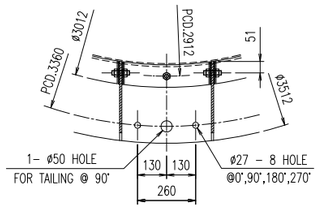

SECTION A-A
SCALE 1.5:1

DETAIL WELD
JOINT "H"

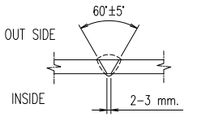

DETAIL WELD
JOINT "I"

16	PIPE SUPPORT	SB-265 Gr.2	3	EA	THK.10mm.
15	STUD BOLT1-NUT2 (GAVZ.)	SA-193-B7 / SA-194-2H	24	SET	3/4" x L110mm.
14	STUD BOLT1-NUT2 (GAVZ.)	SA-193-B7 / SA-194-2H	48	SET	3/4" x L85mm.
13	CLIP SUPPORT TOP&BOTTOM	SB-265 Gr.2	2	SET	THK.6mm.
12	STIFFENER RING TOP&BOTTOM	SB-265 Gr.2	2	EA	THK.6mm.
11	CLIP LOCK GUSSET PLATE	SB-265 Gr.2	46	EA	THK.6mm.
10	TOP PLATE SUPPORT LEGS	SA-36	1	EA	THK.12mm.
9	BASE PLATE SUPPORT LEGS	SA-36	1	EA	THK.35mm.
8	GUSSET PLATE SUPPORT LEGS	SA-36	24	EA	THK.10mm.
7	PAD LIFTING LUG	SB-265 Gr.2	2	EA	180x220xTHK.8mm.
6	PAD LIFTING LUG	SB-265 Gr.2	2	EA	60x220xTHK.8mm.
5	STIFFENER LIFTING LUG	SB-265 Gr.2	2	EA	THK.12mm.
4	LIFTING LUG	SB-265 Gr.2	2	EA	THK.16mm.
3	ELLIP.HEAD	SB-265 Gr.2	1	EA	MIN. 6.5t A/F
2	ELLIP.HEAD	SB-265 Gr.2	1	EA	MIN. 5t A/F
1	SHELL	SB-265 Gr.2	1	EA	ID.2800xH6650xTHK.6mm.
NO	NAME OF PART	MATERIAL	Q'TY	UNIT	REMARKS

BILL OF MATERIAL (PER ITEM)

NOTE:

1. ALL DIMENSIONS ARE IN MILLIMETER UNLESS OTHERWISE SPECIFIED.
2. ALL FLANGE BOLT HOLES SHALL STRADDLE CENTER LINE AXIS OR HORIZONTAL AND VERTICAL AXIS OF THE VESSEL, UNLESS OTHER WISE SPECIFIED.

REV.	DESCRIPTION	DWN	CHIEF	MGR	APVD	AUTH	ISSUE	DATE
	AS BUILT	SRWP		NRRJ	NRRJ		C L F V	18/4/23

PROJECT :

TITANIUM TANK RECYCLE DRUM (E-VE-IC)

MORITANI SINGAPORE PTE.LTD.
KASHIMA CHEMICAL CO.,LTD. ABBR. FOR ISSUE

THIS DOCUMENT EMBODIES PROPRIETARY INFORMATION OF PROLOG TITANIUM CORPORATION CO.,Ltd. THIS DOCUMENT OR THE MATERIAL DESCRIBED THEREON MAY NOT BE COPIED OR DISCLOSED IN ANY FORM OR MEDIUM TO THIRD PARTIES,OR USED FOR OTHER THAN THE PURPOSE WHICH IT HAS BEEN PROVIDED,IN WHOLE OR IN PART IN ANY MANNER EXCEPT AS EXPRESSLY PERMITTED BY PROLOG TITANIUM CORPORATION CO.,Ltd.

ABBR. FOR ISSUE
C = CUSTOMER
L = LICENSOR
F = FIELD
V = VENDOR

PROLOG TITANIUM CORPORATION CO.,Ltd.
WWW.TITANIUM.CO.TH
PTC. JOB NO. 2211120 | ACCOUNT | CUSTOMER'S ORDER NO.

ISSUE MARK — | 18/4/23


DRAWING TITLE :

TITANIUM TANK RECYCLE DRUM
GENERAL ARRAGEMENT DRAWING

1/5

SCALE – | DWG. NO. PTC.2211120-1
SIZE: A3 | REF. NO. Z-9413-0

DWG. NO. PTC.2211120-2

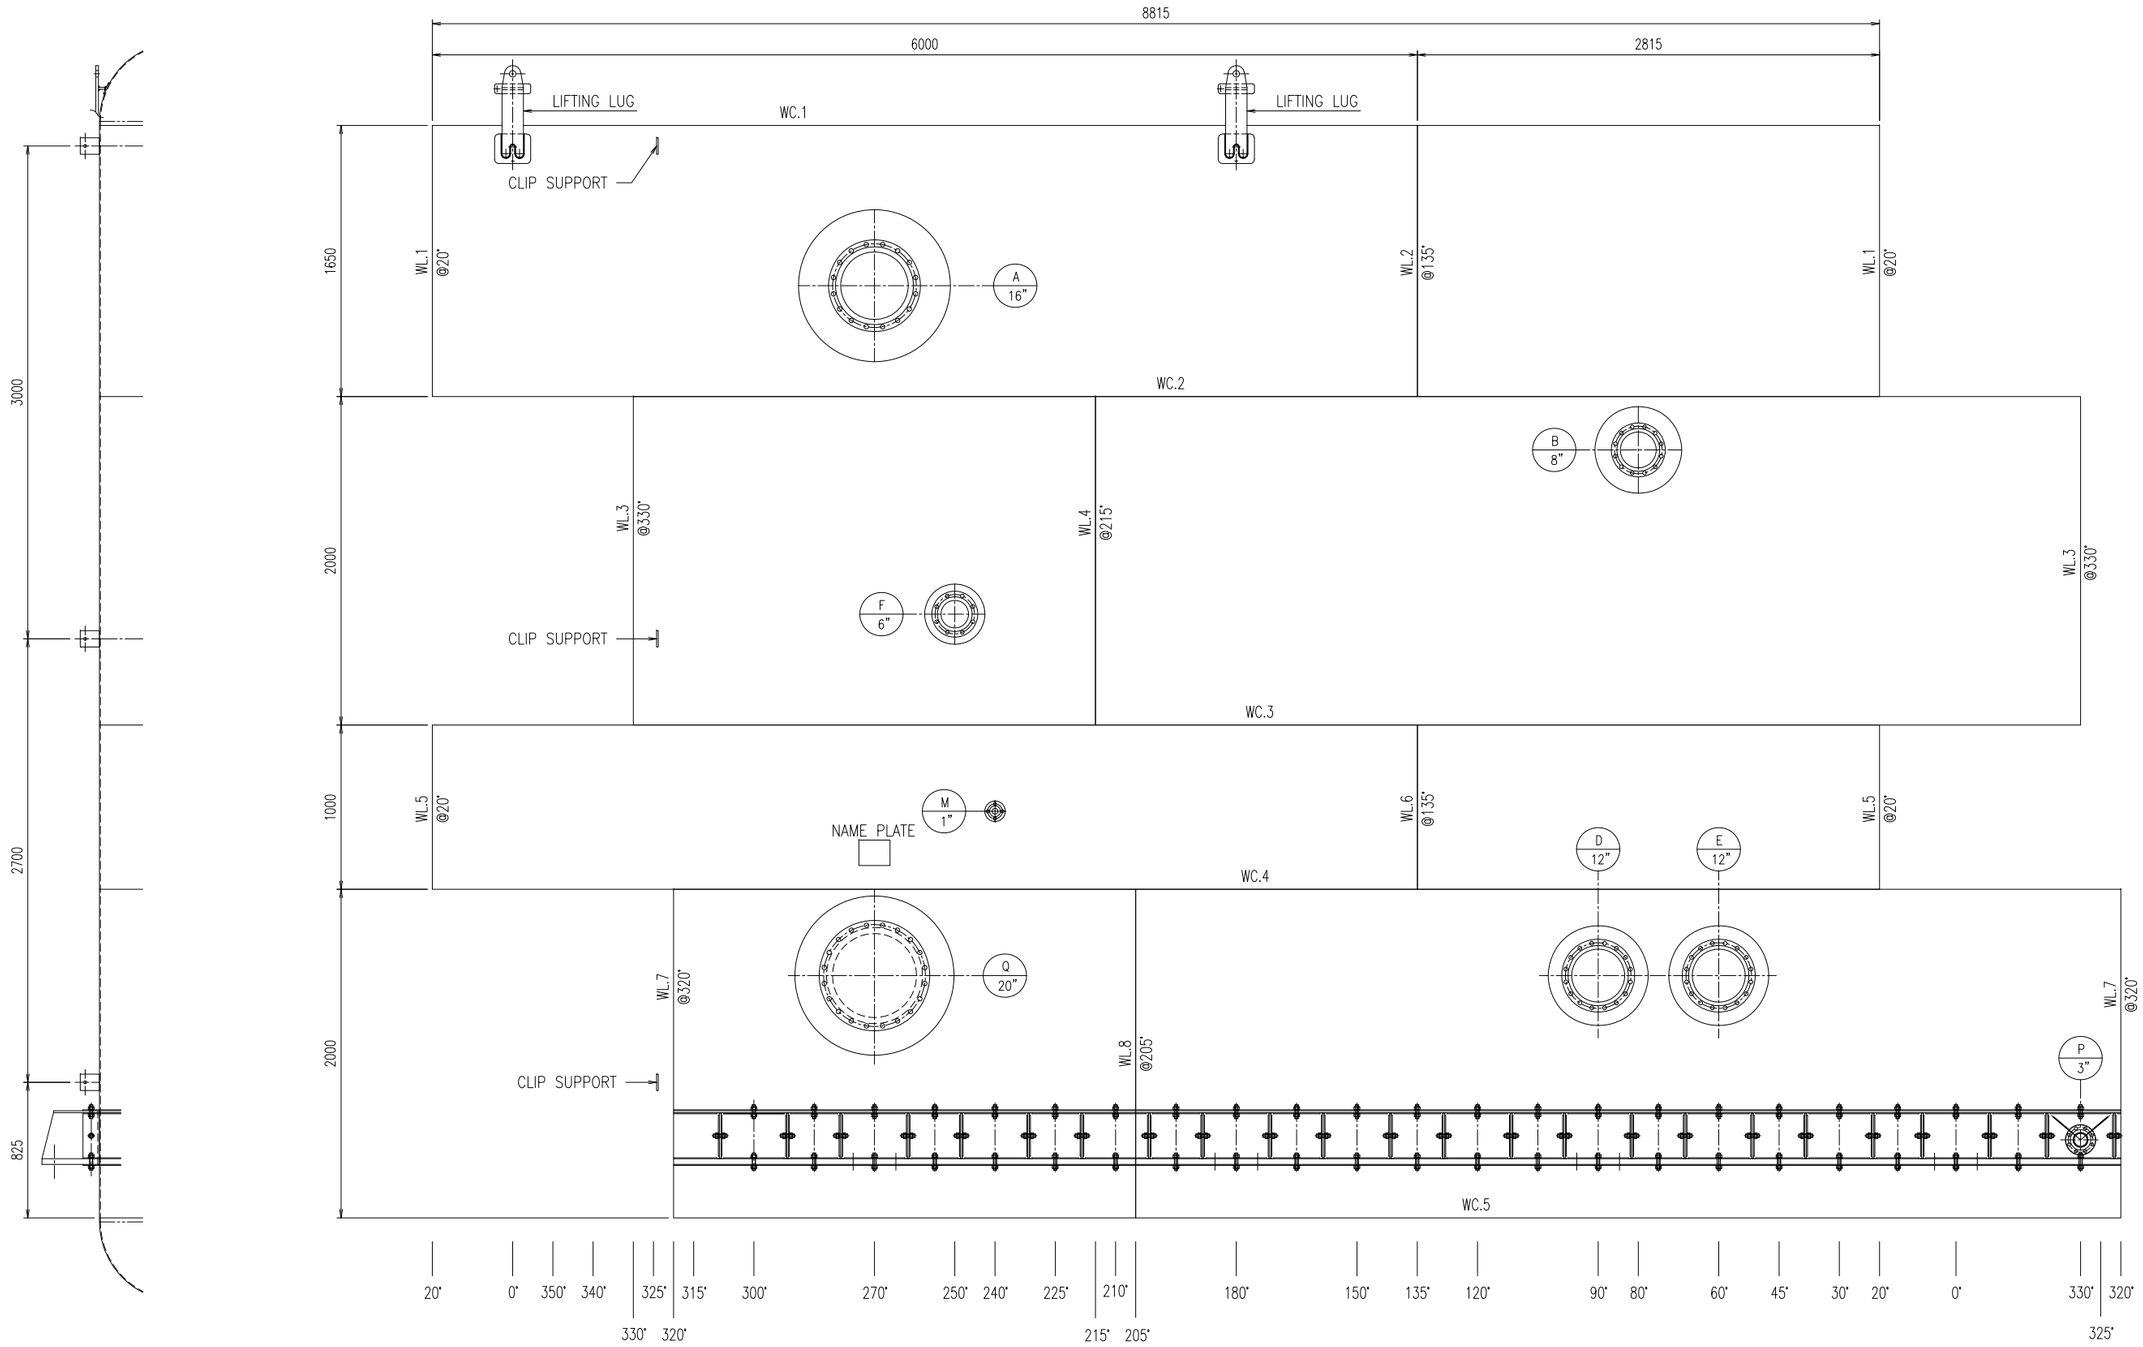

ARRANGEMENT OF SHELL PLATE OUTSIDE VIEW

REV.	DESCRIPTION	DWN	CHIEF	MGR	APVD	AUTH	ISSUE	DATE
	AS BUILT	SRWP		NRRJ	NRRJ		C L F V	18/4/23

PROJECT :
TITANIUM TANK RECYCLE DRUM (E-VE-IC)

MORITANI SINGAPORE PTE.LTD.
KASHIMA CHEMICAL CO.,LTD.

THIS DOCUMENT EMBODIES PROPRIETARY INFORMATION OF PROLOG TITANIUM CORPORATION CO.,Ltd. THIS DOCUMENT OR THE MATERIAL DESCRIBED THEREON MAY NOT BE COPIED OR DISCLOSED IN ANY FORM OR MEDIUM TO THIRD PARTIES,OR USED FOR OTHER THAN THE PURPOSE WHICH IT HAS BEEN PROVIDED,IN WHOLE OR IN PART IN ANY MANNER EXCEPT AS EXPRESSLY PERMITTED BY PROLOG TITANIUM CORPORATION CO.,Ltd.

ABBR. FOR ISSUE
C = CUSTOMER
L = LICENSOR
F = FIELD
V = VENDOR

PROLOG TITANIUM CORPORATION CO.,Ltd.
WWW.TITANIUM.CO.TH
PTC. JOB NO. 2211120 | ACCOUNT | CUSTOMER'S ORDER NO.


ISSUE MARK
–
18/4/23

DRAWING TITLE :
TITANIUM TANK RECYCLE DRUM
ARRANGEMENT OF SHELL


2/5

SCALE – | DWG. NO. PTC.2211120-2
SIZE: A3 | REF. NO. –


DWG. NO. PTC.2211120-3

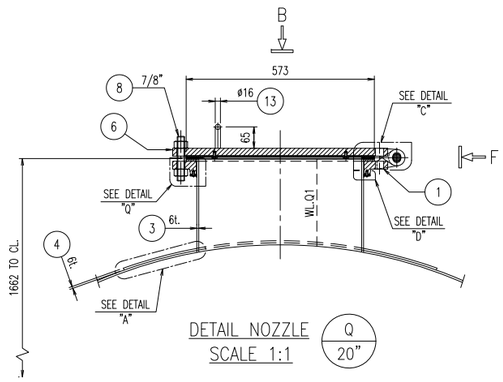


DETAIL NOZZLE Q 20" SCALE 1:1

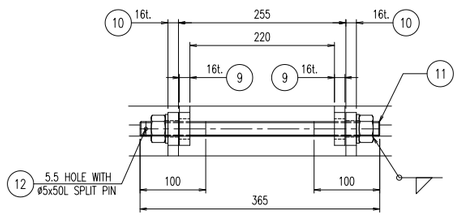


VIEW F SCALE 2:1

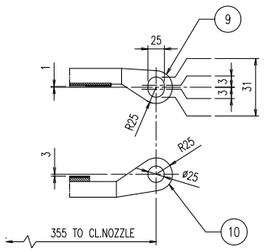


DETAIL C SCALE 2:1

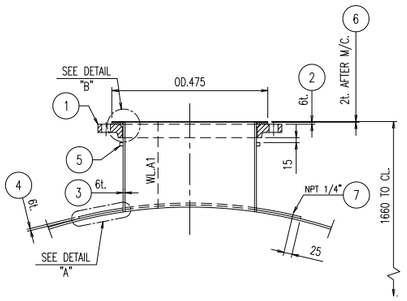

DETAIL NOZZLE A 16" SCALE 1:1

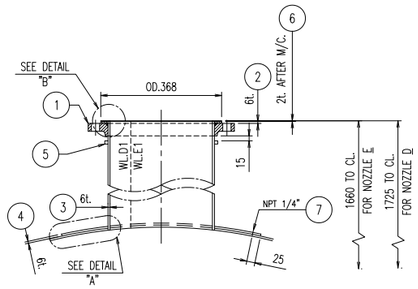


DETAIL NOZZLE D 12" E 12" SCALE 1:1

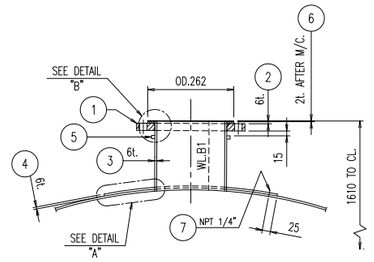


DETAIL NOZZLE B 8" SCALE 1:1


PART LIST																	
NO.	NAME OF PART	SIZE	Q'TY / EA	MATERIAL	REMARK	NO.	NAME OF PART	SIZE	Q'TY / EA	MATERIAL	REMARK	NO.	NAME OF PART	SIZE	Q'TY / EA	MATERIAL	REMARK
1	LJ-FF FLANGE JIS 10K FF. (HDG.)	16"	1	SS400	–	1	LJ-FF FLANGE JIS 10K FF. (HDG.)	12"	2	SS400	–	1	LJ-FF FLANGE JIS 10K FF. (HDG.)	8"	1	SS400	–
2	COLLARING	THK.6mm.	1	SB-265 Gr.2	–	2	COLLARING	THK.6mm.	2	SB-265 Gr.2	–	2	COLLARING	THK.6mm.	1	SB-265 Gr.2	–
3	NECK	OD.406.4 x 6t	1	SB-862 Gr.2	–	3	NECK	OD.323.85 x 6t	2	SB-862 Gr.2	–	3	NECK	OD.219 x 6t	1	SB-862 Gr.2	–
4	PAD	OD.926x6t	1	SB-265 Gr.2	–	4	PAD	OD.610x8t	2	SB-265 Gr.2	–	4	PAD	OD.530x6t	1	SB-265 Gr.2	–
5	STOPPER	10 x 10 mm.	4	SB-265 Gr.2	–	5	STOPPER	10 x 10 mm.	8	SB-265 Gr.2	–	5	STOPPER	10 x 10 mm.	4	SB-265 Gr.2	–
6	COLLARING LINING	2t AFTER M/C	1	SB-265 Gr.7	–	6	COLLARING LINING	2t AFTER M/C	2	SB-265 Gr.7	–	6	COLLARING LINING	2t AFTER M/C	1	SB-265 Gr.7	–
7	PLUG	1/4" NPT	1	SUS304	–	7	PLUG	1/4" NPT	2	SUS304	–	7	PLUG	1/4" NPT	1	SUS304	–

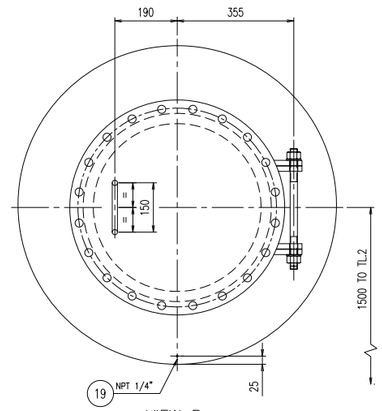


VIEW B SCALE 1:1

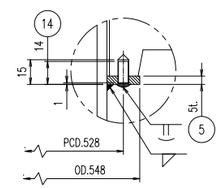

DETAIL D

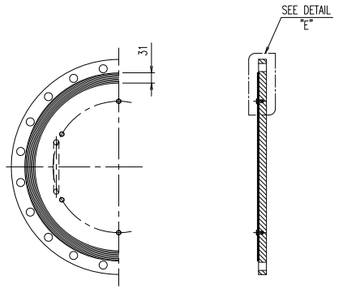


DETAIL BLIND FLANGE

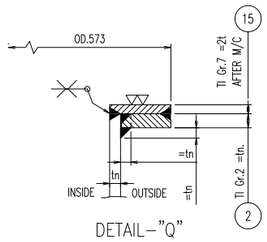


DETAIL-"Q"


PART LIST					
NO.	NAME OF PART	SIZE	Q'TY / EA	MATERIAL	REMARK
1	LJ-FF FLANGE JIS 5K FF. (HDG.)	20"	1	SS400	–
2	COLLARING	THK.6mm.	1	SB-265 Gr.2	–
3	NECK	OD.508 x 6t	1	SB-862 Gr.2	–
4	PAD	OD.970x6t	1	SB-265 Gr.2	–
5	RING PLATE LOCK FLANGE	OD.548xID.510xTHK.5MM.	1	SB-265 Gr.2	–
6	BLIND FLANGE JIS 5K FF	20"	1	SS400(HDG.)	–
7	GASKET FOR FLANGE JIS 5K RF	20" THK.4mm.	1	PTFE	–
8	STUD BOLT/NUT 2 (HDG.)	7/8" x135L	20	SA193 B7/SA194 2H	–
9	HINGE TOP	PL.-16t	2	SS400	–
10	HINGE BOTTOM	PL.-16t	2	SS400	–
11	STUD BOLT/NUT 2/FLAT WASHER 2 (HDG.)	7/8" x365L	1	SA193 B7/SA194 2H	–
12	SPLIT PIN	ø5x50L	1	SUS304	–
13	HANDEL	RB.ø16	1	SS400	–
14	PIN LOCK	RB.ø6	10	SB-348 Gr.2	–
15	COLLARING LINING	2t AFTER M/C	1	SB-265 Gr.7	–
16	LINING PLATE	THK.3mm.	1	SB-265 Gr.2	–
17	LINING RING	2t AFTER M/C	1	SB-265 Gr.7	–
18	HEX BOLT LOCK LINING PLATE	M8xL13	6	SB-348 Gr.2	–
19	PLUG	1/4" NPT	1	SUS304	–

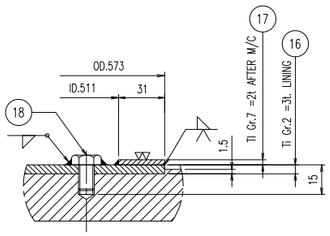

DETAIL E

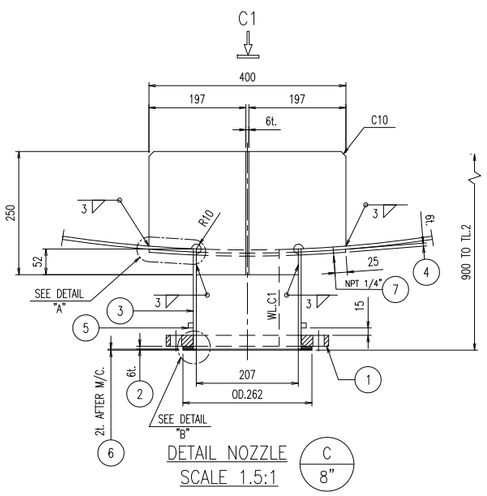


DETAIL NOZZLE C 8" SCALE 1.5:1

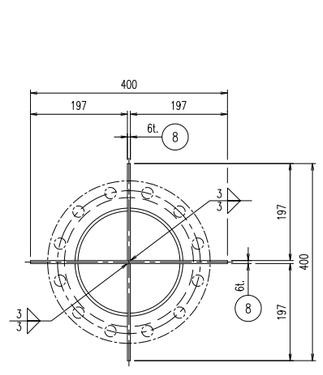


VIEW C1 SCALE 1.5:1


PART LIST					
NO.	NAME OF PART	SIZE	Q'TY / EA	MATERIAL	REMARK
1	LJ-FF FLANGE JIS 10K FF. (HDG.)	8"	1	SS400	–
2	COLLARING	THK.6mm.	1	SB-265 Gr.2	–
3	NECK	OD.219 x 6t	1	SB-862 Gr.2	–
4	PAD	OD.400x6t	1	SB-265 Gr.2	–
5	STOPPER	10 x 10 mm.	4	SB-265 Gr.2	–
6	COLLARING LINING	2t AFTER M/C	1	SB-265 Gr.7	–
7	PLUG	1/4" NPT	1	SUS304	–
8	VORTEX BREAKER	THK.6mm.	1 SET	SB-265 Gr.2	–

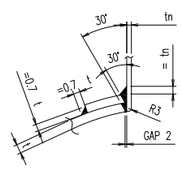


DETAIL-"A"

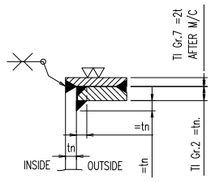

DETAIL-"B"

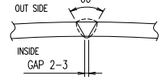


DETAIL WELD JOINT WL.A1,B1,C1,D1,E1,Q1

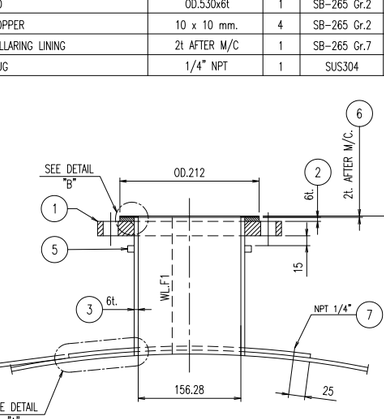

DETAIL NOZZLE F 6" SCALE 2:1

PART LIST					
NO.	NAME OF PART	SIZE	Q'TY / EA	MATERIAL	REMARK
1	LJ-FF FLANGE JIS 10K FF. (HDG.)	6"	1	SS400	–
2	COLLARING	THK.6mm.	1	SB-265 Gr.2	–
3	NECK	OD.168 x 6t	1	SB-862 Gr.2	–
4	PAD	OD.368 x 6t	1	SB-265 Gr.2	–
5	STOPPER	10 x 10 mm.	4	SB-265 Gr.2	–
6	COLLARING LINING	2t AFTER M/C	1	SB-265 Gr.7	–
7	PLUG	1/4" NPT	1	SUS304	–

1. ALL REINFORCEMENT PADS SHALL BE PROVIDED ON NPT 1/4" TELL TALE HOLE WITH 304 S.S PLUG
   a) LOCATION SHALL BE AS FOLLOWS :

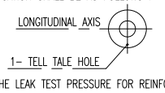

   b) THE LEAK TEST PRESSURE FOR REINFORCEMENT PADS SHALL BE 1.05 kg/cm G.

REV.	DESCRIPTION	DWN	CHIEF	MGR	APVD	AUTH	ISSUE	DATE
	AS BUILT	SRWP		NRRJ	NRRJ		C L F V	18/4/23

PROJECT :

TITANIUM TANK RECYCLE DRUM (E-VE-IC)

MORITANI SINGAPORE PTE.LTD.
KASHIMA CHEMICAL CO.,LTD.

THIS DOCUMENT EMBODIES PROPRIETARY INFORMATION OF PROLOG TITANIUM CORPORATION CO.,Ltd. THIS DOCUMENT OR THE MATERIAL DESCRIBED THEREON MAY NOT BE COPIED OR DISCLOSED IN ANY FORM OR MEDIUM TO THIRD PARTIES,OR USED FOR OTHER THAN THE PURPOSE WHICH IT HAS BEEN PROVIDED,IN WHOLE OR IN PART IN ANY MANNER EXCEPT AS EXPRESSLY PERMITTED BY PROLOG TITANIUM CORPORATION CO.,Ltd.

ABBR. FOR ISSUE
C = CUSTOMER
L = LICENSOR
F = FIELD
V = VENDOR

ISSUE MARK
–
18/4/23

PROLOG TITANIUM CORPORATION CO.,Ltd.
WWW.TITANIUM.CO.TH
PTC. JOB NO. 2211120 | ACCOUNT | CUSTOMER'S ORDER NO.

DRAWING TITLE :
TITANIUM TANK RECYCLE DRUM
DETAIL NOZZLE


3/5

SCALE – | SIZE: A3

DWG. NO. PTC.2211120-3


REF. NO. Z-9413-1

DWG. NO. PTC.2211120-4

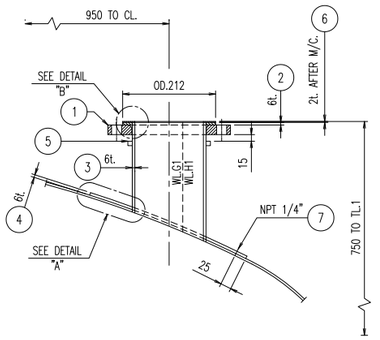

DETAIL NOZZLE
SCALE 1:1


G 6" | H 6"

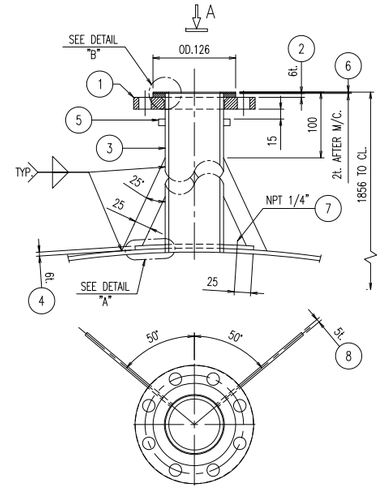

VIEW A


DETAIL NOZZLE
SCALE 1.5:1

L2 | 3"

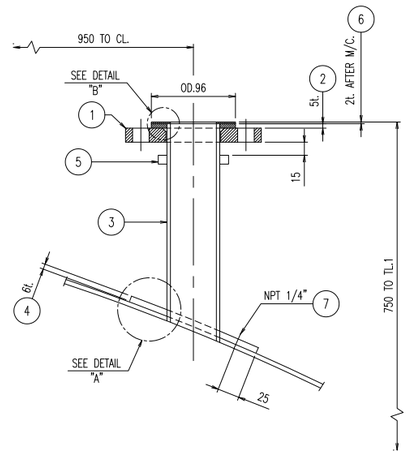


DETAIL NOZZLE
SCALE 2:1

J | 2"

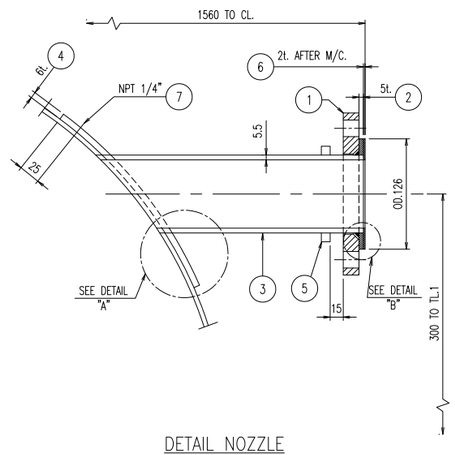


DETAIL NOZZLE
SCALE 2:1


L1 | 3"

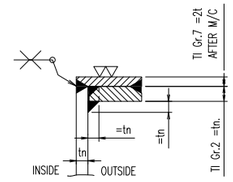

DETAIL–"B"

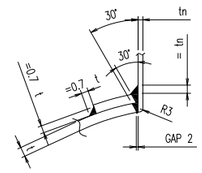

DETAIL–"A"

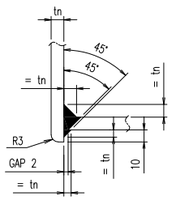

DETAIL–"C"

PART LIST

NO.	NAME OF PART	SIZE	Q'TY / EA	MATERIAL	REMARK
1	LJ–FF FLANGE JIS 10K FF. (HDG.)	6"	2	SS400	–
2	COLLARING	THK.6mm.	2	SB–265 Gr.2	–
3	NECK	OD.168.3 x 6t	2	SB–862 Gr.2	–
4	PAD	OD.385x6t	2	SB–265 Gr.2	–
5	STOPPER	10 x 10 mm.	8	SB–265 Gr.2	–
6	COLLARING LINING	2t AFTER M/C	2	SB–265 Gr.7	–
7	PLUG	1/4" NPT	2	SUS304	–

PART LIST


NO.	NAME OF PART	SIZE	Q'TY / EA	MATERIAL	REMARK
1	LJ–FF FLANGE JIS 10K FF. (HDG.)	3"	1	SS400	–
2	COLLARING	THK.6mm.	1	SB–265 Gr.2	–
3	NECK	PIPE 3" SCH.40	1	SB–861 Gr.2	–
4	PAD	OD.180x6t	1	SB–265 Gr.2	–
5	STOPPER	10 x 10 mm.	3	SB–265 Gr.2	–
6	COLLARING LINING	2t AFTER M/C	1	SB–265 Gr.7	–
7	PLUG	1/4" NPT	1	SUS304	–
8	LIP PLATE	THK.5mm.	2	SB–265 Gr.2	–


PART LIST

NO.	NAME OF PART	SIZE	Q'TY / EA	MATERIAL	REMARK
1	LJ–FF FLANGE JIS 10K FF. (HDG.)	2"	1	SS400	–
2	COLLARING	THK.5mm.	1	SB–265 Gr.2	–
3	NECK	PIPE 2" SCH.40	1	SB–265 Gr.2	–
4	PAD	OD.156x6t	1	SB–265 Gr.2	–
5	STOPPER	10 x 10 mm.	2	SB–265 Gr.2	–
6	COLLARING LINING	2t AFTER M/C	1	SB–265 Gr.7	–
7	PLUG	1/4" NPT	1	SUS304	–

PART LIST

NO.	NAME OF PART	SIZE	Q'TY / EA	MATERIAL	REMARK
1	LJ–FF FLANGE JIS 10K FF. (HDG.)	3"	1	SS400	–
2	COLLARING	THK.5mm.	1	SB–265 Gr.2	–
3	NECK	PIPE 3" SCH.40	1	SB–861 Gr.2	–
4	PAD	OD.180x6t	1	SB–265 Gr.2	–
5	STOPPER	10 x 10 mm.	2	SB–265 Gr.2	–
6	COLLARING LINING	2t AFTER M/C	1	SB–265 Gr.7	–
7	PLUG	1/4" NPT	1	SUS304	–

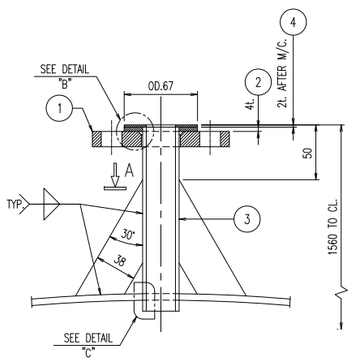


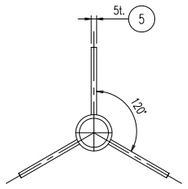


VIEW A

DETAIL NOZZLE
SCALE 2.5:1

M | 1"

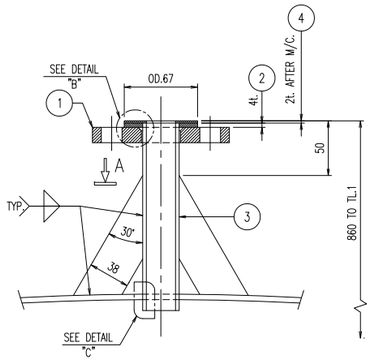


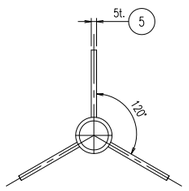

VIEW A

DETAIL NOZZLE
SCALE 2.5:1

K | 1"

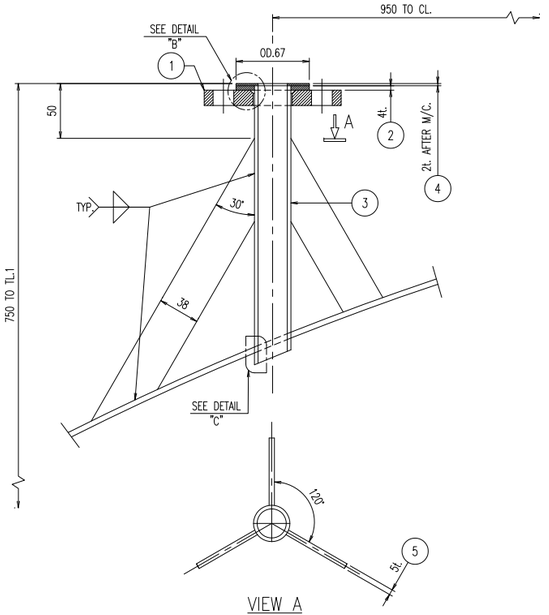

VIEW A

DETAIL NOZZLE
SCALE 2.5:1

N | 1"

PART LIST

NO.	NAME OF PART	SIZE	Q'TY / EA	MATERIAL	REMARK
1	LJ–FF FLANGE JIS 10K FF. (HDG.)	1"	1	SS400	–
2	COLLARING	THK.4mm.	1	SB–265 Gr.2	–
3	NECK	PIPE 1" SCH.40	1	SB–861 Gr.2	–
4	COLLARING LINING	2t AFTER M/C	1	SB–265 Gr.7	–
5	LIP PLATE	THK.5mm.	3	SB–265 Gr.2	–

NOTE :

1. ALL REINFORCEMENT PADS SHALL BE PROVIDED ON NPT 1/4" TELL TALE HOLE WITH 304 S.S PLUG
   a) LOCATION SHALL BE AS FOLLOWS :

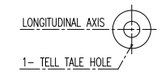

   b) THE LEAK TEST PRESSURE FOR REINFORCEMENT PADS SHALL BE 1.05 kg/cm G.

REV.	DESCRIPTION	DWN	CHIEF	MGR	APVD	AUTH	ISSUE	DATE
	AS BUILT	SRWP		NRRJ	NRRJ		C L F V	18/4/23

PROJECT :
TITANIUM TANK RECYCLE DRUM (E–VE–IC)

MORITANI SINGAPORE PTE.LTD.
KASHIMA CHEMICAL CO.,LTD.

THIS DOCUMENT EMBODIES PROPRIETARY INFORMATION OF PROLOG TITANIUM CORPORATION CO.,Ltd. THIS DOCUMENT OR THE MATERIAL DESCRIBED THEREON MAY NOT BE COPIED OR DISCLOSED IN ANY FORM OR MEDIUM TO THIRD PARTIES,OR USED FOR OTHER THAN THE PURPOSE WHICH IT HAS BEEN PROVIDED,IN WHOLE OR IN PART IN ANY MANNER EXCEPT AS EXPRESSLY PERMITTED BY PROLOG TITANIUM CORPORATION CO.Ltd.

ABBR. FOR ISSUE
C = CUSTOMER
L = LICENSOR
F = FIELD
V = VENDOR

ISSUE MARK
–
18/4/23

PROLOG TITANIUM CORPORATION CO.,Ltd.
WWW.TITANIUM.CO.TH
PTC. JOB NO. 2211120 | ACCOUNT | CUSTOMER'S ORDER NO.


DRAWING TITLE :
TITANIUM TANK RECYCLE DRUM
DETAIL NOZZLE

4/5


SCALE – | DWG. NO. PTC.2211120–4
SIZE: A3 | REF. NO. Z–9413–1


DWG. NO. PTC.2211120-5

DETAIL PART LIST (PER ITEM)				
PART NAME				
NO.	NAME OF PART	MATERIAL	Q'TY / EA	REMARK
1	NAME PLATE	SUS304	1	THK.2mm.
2	SUPPORT NAME PLATE	SB265-Gr.2	1	THK.2mm.
3	HEX BOLTS	SUS304	4	M4 x L10 mm.
4	HEX NUTS	SUS304	4	M4

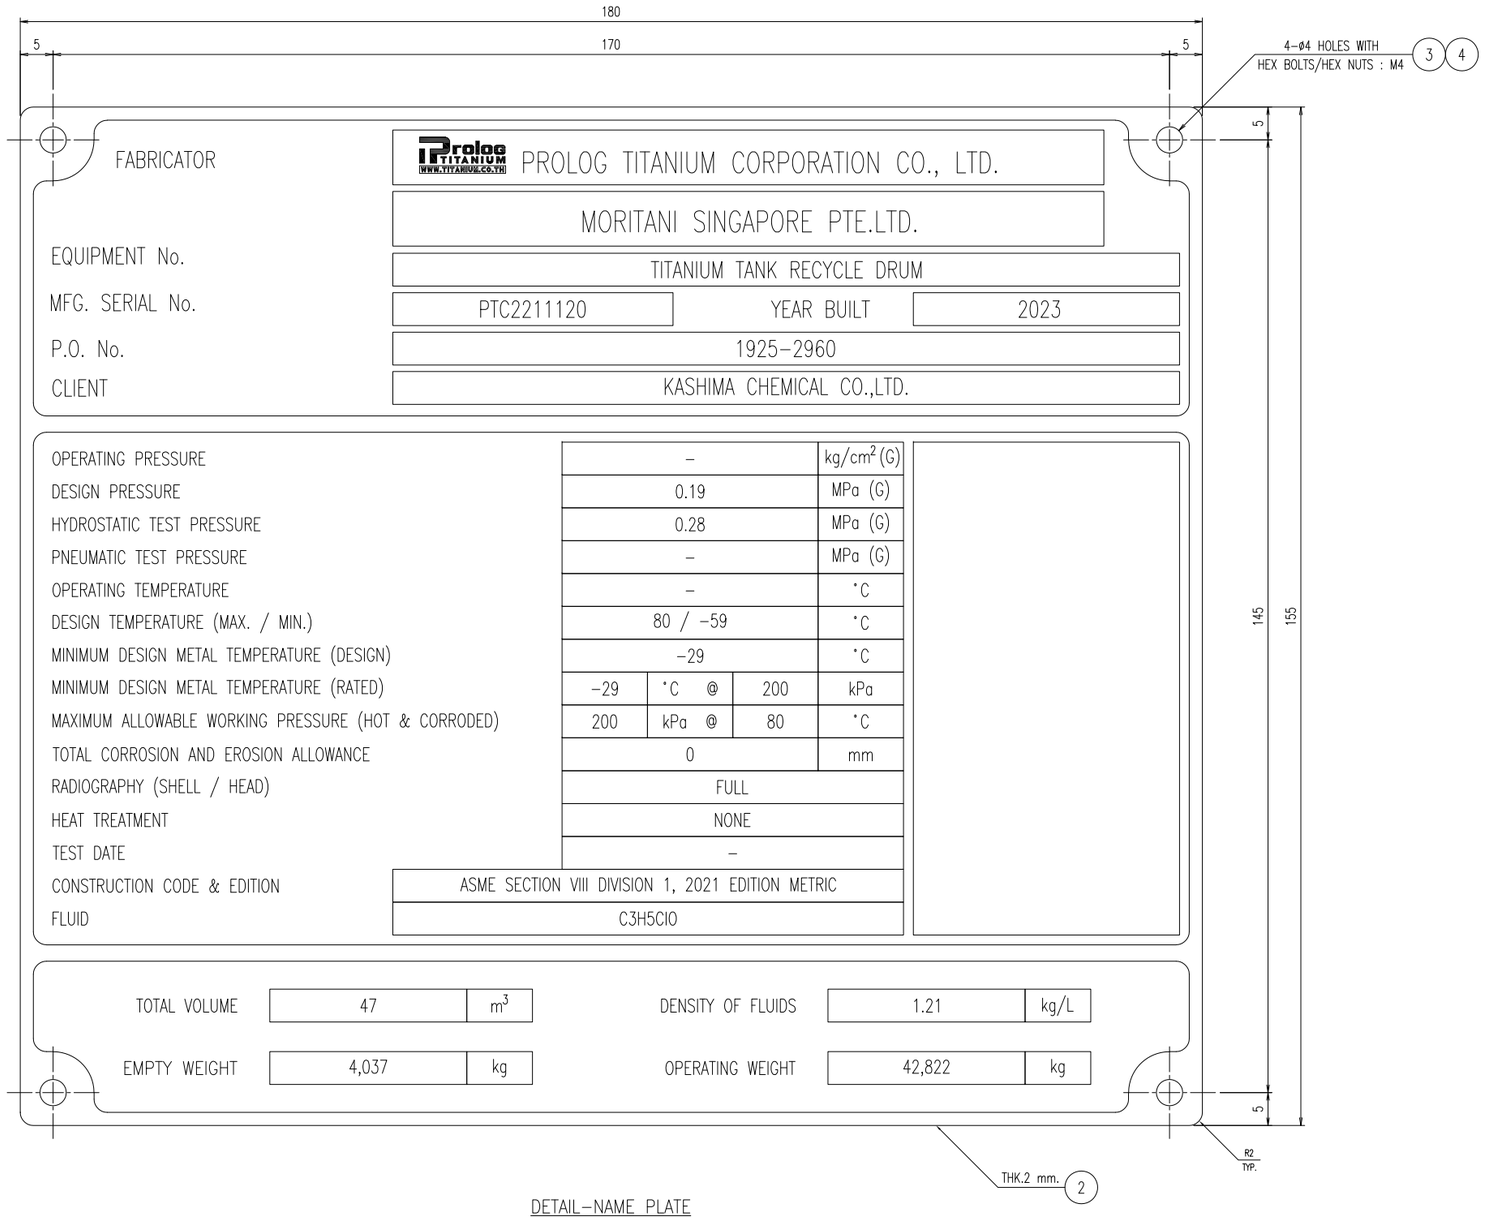

DETAIL-NAME PLATE
SCALE 30:1

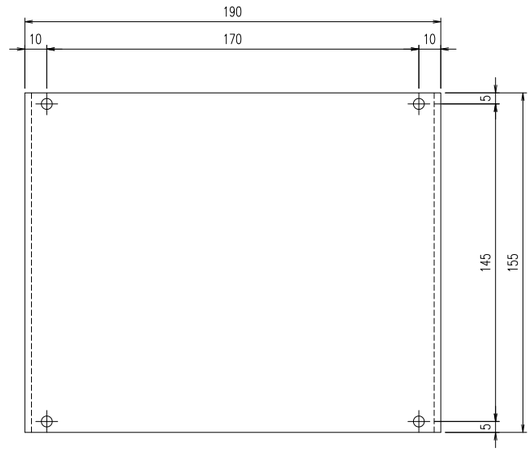

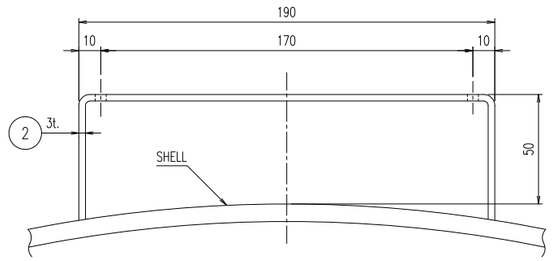

DETAIL-BRACKET
SCALE 10:1

REV.	DESCRIPTION	DWN	CHIEF	MGR	APVD	AUTH	ISSUE	DATE
	AS BUILT	SRWP		NRRJ	NRRJ		C L F V	18/4/23

PROJECT :
TITANIUM TANK RECYCLE DRUM
MORITANI SINGAPORE PTE.LTD.
KASHIMA CHEMICAL CO.,LTD.

THIS DOCUMENT EMBODIES PROPRIETARY INFORMATION OF PROLOG TITANIUM CORPORATION CO.,Ltd. THIS DOCUMENT OR THE MATERIAL DESCRIBED THEREON MAY NOT BE COPIED OR DISCLOSED IN ANY FORM OR MEDIUM TO THIRD PARTIES,OR USED FOR OTHER THAN THE PURPOSE WHICH IT HAS BEEN PROVIDED,IN WHOLE OR IN PART IN ANY MANNER EXCEPT AS EXPRESSLY PERMITTED BY PROLOG TITANIUM CORPORATION CO.,Ltd.

ABBR. FOR ISSUE
C = CUSTOMER
L = LICENSOR
F = FIELD
V = VENDOR

ISSUE MARK –
18/4/23

PROLOG TITANIUM CORPORATION CO.,Ltd.
PTC. JOB NO. 2211120 ACCOUNT CUSTOMER'S ORDER NO.

DRAWING TITLE :
TITANIUM TANK RECYCLE DRUM
DETAIL NAME PLATE
5/5

SCALE –
SIZE: A3
DWG. NO. PTC.2211120-5
REF. NO. –